



HDFC BANK DEHU GAON BRANCH, PUNE - PROPOSED PLAN- OPTION 2

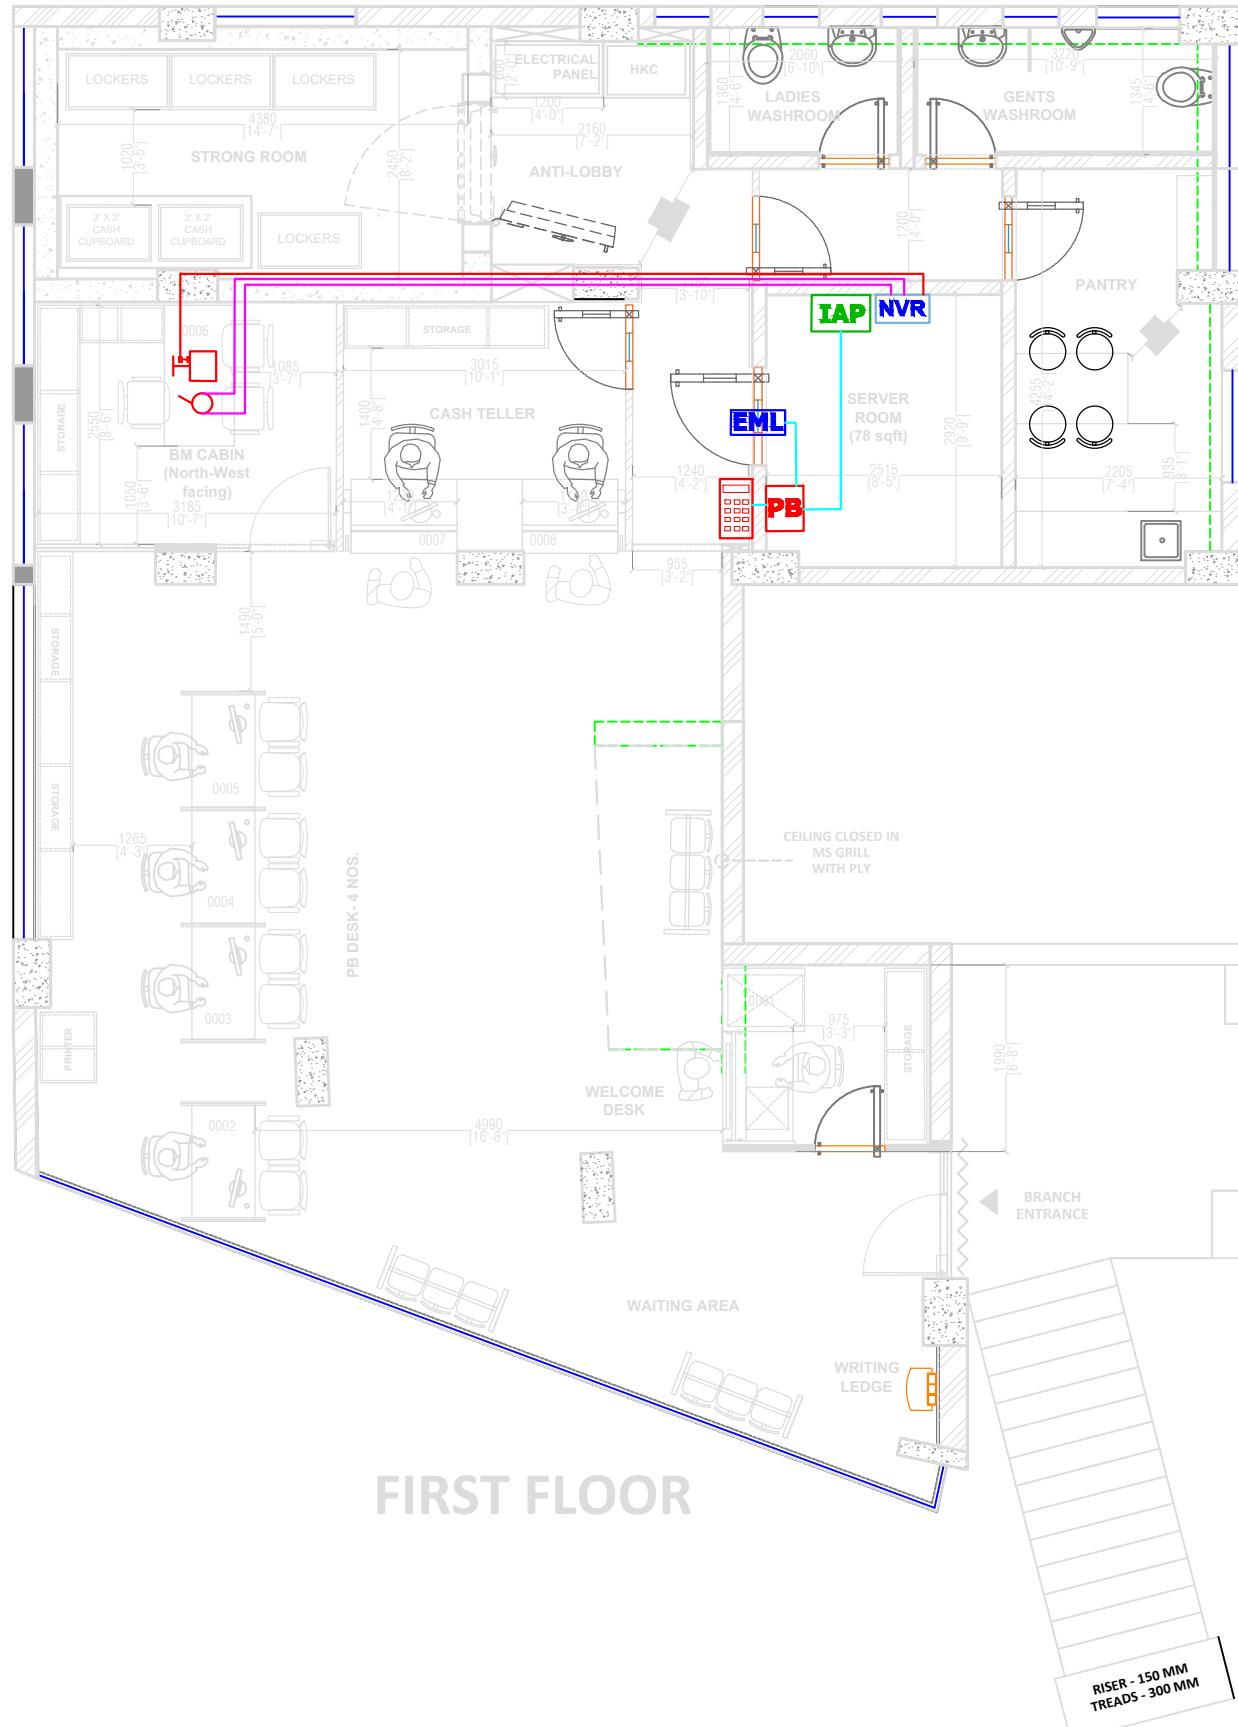

CLIENT:	HDFC BANK
PROJECT TYPE:	TIER II-III
GROUND FLOOR SB HT:	2755 MM
GROUND FLOOR BB HT:	2450 MM
1ST FLOOR .SB HT:	2825 MM
1ST FLOOR .BB HT:	2345 MM
DRG TITLE :	PROPOSED PLAN
OPTION :	OPTION 2
DATE :	17-04-25
SCALE :	FIT TO SCALE
DRAWN BY :	SANIYA
CHECKED BY :	ALI
DRG ISSUED FOR :	APPROVAL
 	
NOTE: THIS DRAWING IS THE PROPERTY OF M/s. TEAMSWIFT PROJECTS PVT. LTD. AND IS NOT TO BE REPRODUCED OR HANDED OVER TO A THIRD PARTY OR USE FOR ANY OTHER PURPOSE OTHER THAN FOR WHICH IT IS ISSUED.	
DISCLAIMER: M/s. TEAMSWIFT PROJECTS PVT. LTD. IS NOT RESPONSIBLE FOR STATUTORY/GOVT. APPROVALS WHICH SHALL BE THE OWNER'S RESPONSIBILITY.	
 TEAMSWIFT PROJECTS PVT. LTD. A DESIGN - BUILD, FIT - OUT COMPANY	

HDFC BANK DEHU GAON BRANCH, PUNE - AS-BUILT - LAYOUT

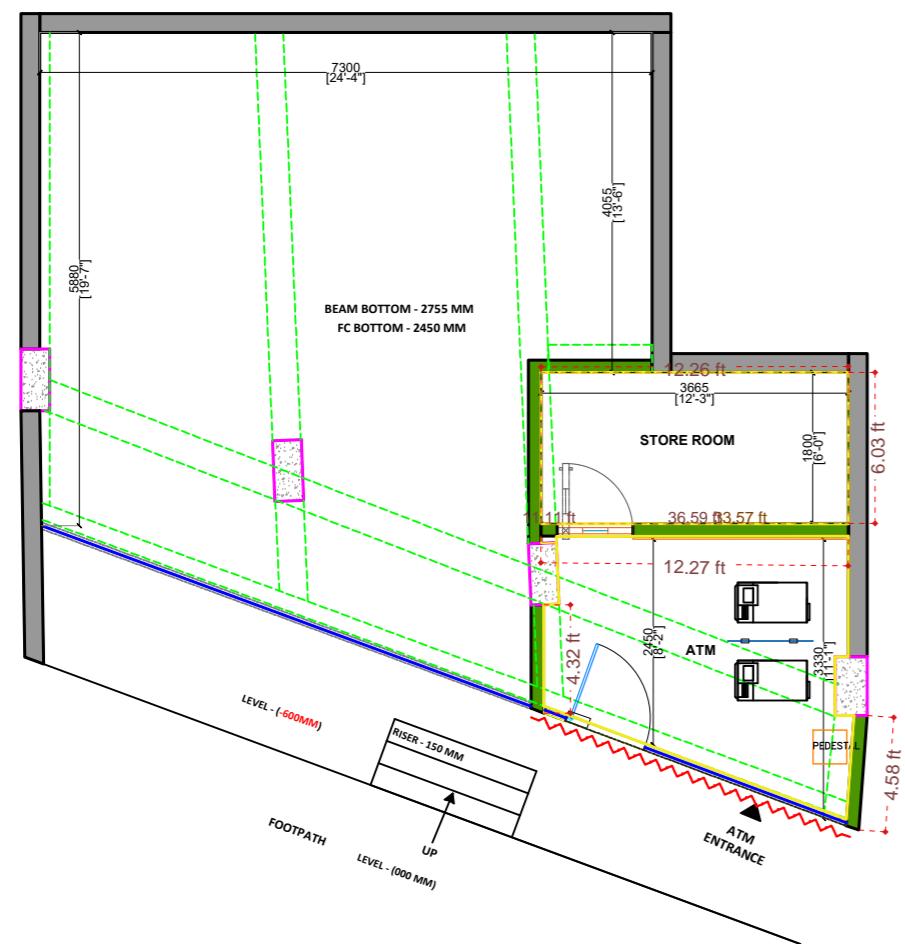

GROUND FLOOR

CLIENT: HDFC BANK

PROJECT TYPE: II-III

GROUND FLOOR SB HT: 2755 MM
GROUND FLOOR BB HT: 2450 MM

1ST FLOOR .SB HT: 2825 MM
1ST FLOOR .BB HT: 2345 MM

DRG TITLE : AS BUILT - LAYOUT
OPTION :
DATE : 11-08-25
SCALE : FIT TO SCALE
DRAWN BY : JAMILA
CHECKED BY : ALI
DRG ISSUED FOR : APPROVAL




NOTE: THIS DRAWING IS THE PROPERTY OF M/s.TEAMSWIFT PROJECTS PVT. LTD. AND IS NOT TO BE REPRODUCED OR HANDED OVER TO A THIRD PARTY OR USE FOR ANY OTHER PURPOSE OTHER THAN FOR WHICH IT IS ISSUED.

DISCLAIMER: M/s TEAMSWIFT PROJECTS PVT. LTD. IS NOT RESPONSIBLE FOR STATUTORY/GOVT. APPROVALS WHICH SHALL BE THE OWNER'S RESPONSIBILITY.

TEAMSWIFT
PROJECTS PVT. LTD.
A DESIGN - BUILD, FIT - OUT COMPANY

HDFC BANK DEHU GAON BRANCH, PUNE - AS-BUILT - LAYOUT

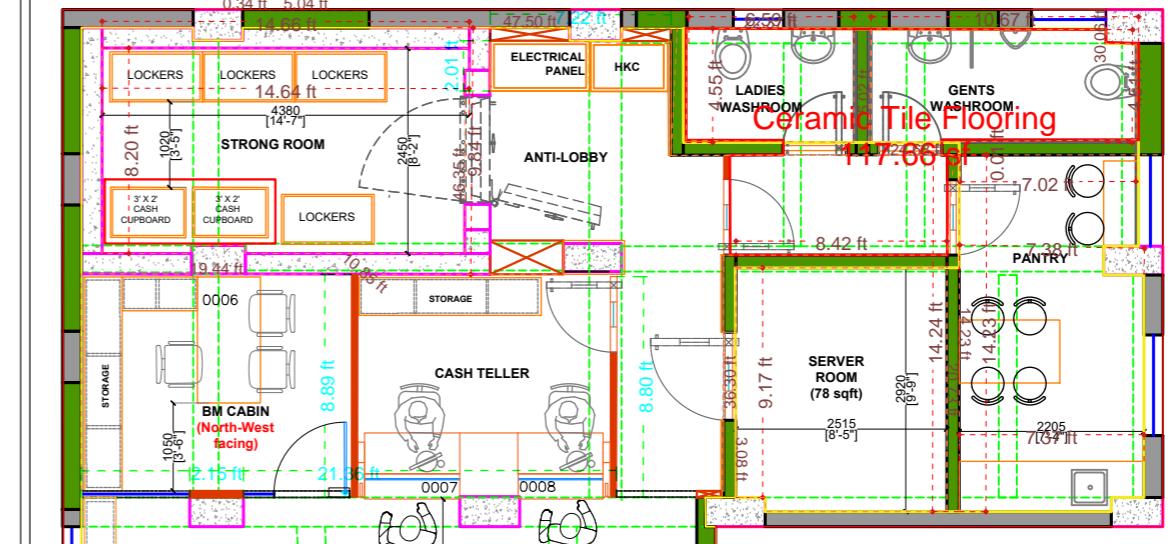

FIRST FLOOR


CLIENT: HDFC BANK

PROJECT TYPE: II-III

GROUND FLOOR SB HT: 2755 MM
GROUND FLOOR BB HT: 2450 MM

1ST FLOOR .SB HT: 2825 MM
1ST FLOOR .BB HT: 2345 MM

DRG TITLE : AS BUILT - LAYOUT
OPTION :
DATE : 11-08-25
SCALE : FIT TO SCALE
DRAWN BY : JAMILA
CHECKED BY : ALI
DRG ISSUED FOR : APPROVAL

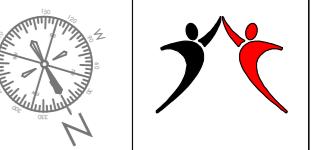


NOTE: THIS DRAWING IS THE PROPERTY OF M/s.TEAMSWIFT PROJECTS PVT. LTD. AND IS NOT TO BE REPRODUCED OR HANDED OVER TO A THIRD PARTY OR USE FOR ANY OTHER PURPOSE OTHER THAN FOR WHICH IT IS ISSUED.

DISCLAIMER: M/s TEAMSWIFT PROJECTS PVT. LTD. IS NOT RESPONSIBLE FOR STATUTORY/GOVT. APPROVALS WHICH SHALL BE THE OWNER'S RESPONSIBILITY.

TEAMSWIFT
PROJECTS PVT. LTD.
A DESIGN - BUILD, FIT - OUT COMPANY

HDFC BANK DEHU GAON BRANCH, PUNE - RFC WITH LIGHTING PLAN

CLIENT:	HDFC BANK
PROJECT TYPE:	II-III
GROUND FLOOR SB HT:	2755 MM
GROUND FLOOR BB HT:	2450 MM
1ST FLOOR .SB HT:	2825 MM
1ST FLOOR .BB HT:	2345 MM
TYPES	
D1	SOLID DOOR WITH GLASS SLIT
D2	SOLID DOOR WITHOUT GLASS SLIT
D3	GLASS DOOR
LEGEND	
	2 X 2 LIGHTS
	SPOT LIGHTS
	SPOT LIGHTS ON UPS
	2 X 2 LIGHTS ON UPS
	ROPE LIGHT
DRG TITLE :	RFC WITH LIGHTING
OPTION :	
DATE :	11-08-25
SCALE :	FIT TO SCALE
DRAWN BY :	JAMILA
CHECKED BY :	ALI
DRG ISSUED FOR :	APPROVAL
<small>NOTE: THIS DRAWING IS THE PROPERTY OF M/s. TEAMSWIFT PROJECTS PVT. LTD. AND IS NOT TO BE REPRODUCED OR HANDED OVER TO A THIRD PARTY OR USE FOR ANY OTHER PURPOSE OTHER THAN FOR WHICH IT IS ISSUED.</small>	
<small>DISCLAIMER: M/s. TEAMSWIFT PROJECTS PVT. LTD. IS NOT RESPONSIBLE FOR STATUTORY/GOVT. APPROVALS WHICH SHALL BE THE OWNER'S RESPONSIBILITY.</small>	

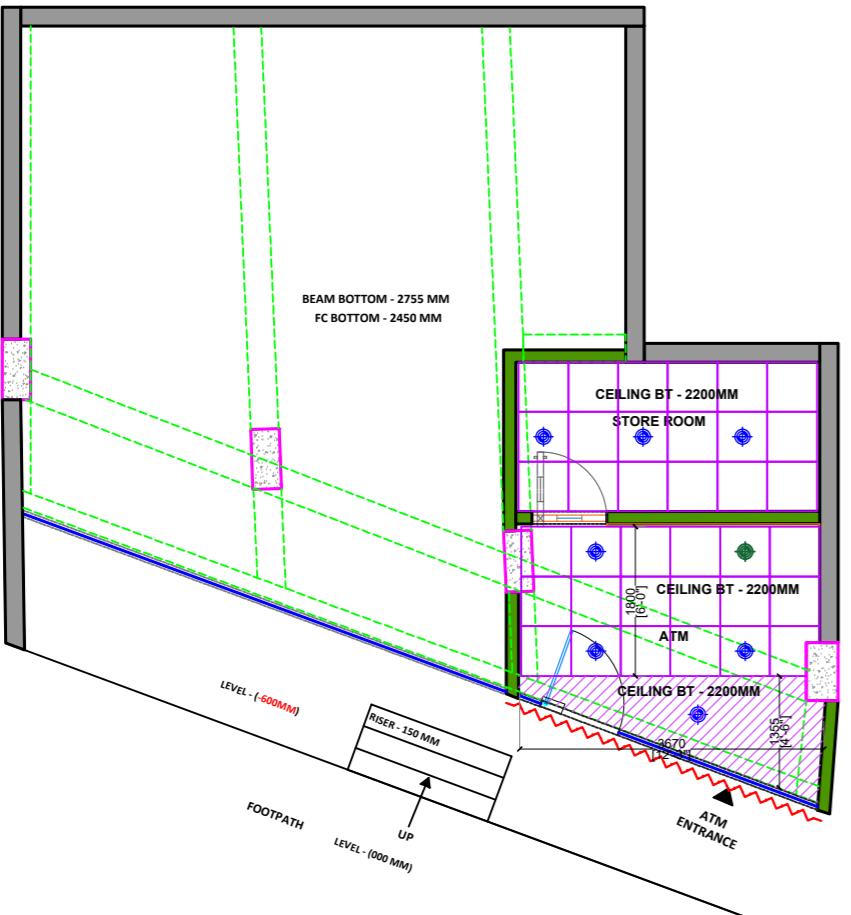


GROUND FLOOR


HDFC BANK DEHU GAON BRANCH, PUNE - RFC WITH LIGHTING PLAN

CLIENT:	HDFC BANK
PROJECT TYPE:	II-III
GROUND FLOOR SB HT:	2755 MM
GROUND FLOOR BB HT:	2450 MM
1ST FLOOR .SB HT:	2825 MM
1ST FLOOR .BB HT:	2345 MM
LEGEND	
	2 X 2 LIGHTS
	SPOT LIGHTS
	SPOT LIGHTS ON UPS
	2 X 2 LIGHTS ON UPS
	ROPE LIGHT
DRG TITLE :	RFC WITH LIGHTING
OPTION :	
DATE :	11-08-25
SCALE :	FIT TO SCALE
DRAWN BY :	JAMILA
CHECKED BY :	ALI
DRG ISSUED FOR :	APPROVAL
<small>NOTE: THIS DRAWING IS THE PROPERTY OF M/s. TEAMSWIFT PROJECTS PVT. LTD. AND IS NOT TO BE REPRODUCED OR HANDED OVER TO A THIRD PARTY OR USE FOR ANY OTHER PURPOSE OTHER THAN FOR WHICH IT IS ISSUED.</small>	
<small>DISCLAIMER: M/s. TEAMSWIFT PROJECTS PVT. LTD. IS NOT RESPONSIBLE FOR STATUTORY/GOVT. APPROVALS WHICH SHALL BE THE OWNER'S RESPONSIBILITY.</small>	


FIRST FLOOR

HDFC BANK DEHU GAON BRANCH, PUNE - PROPOSED PLAN- OPTION 2

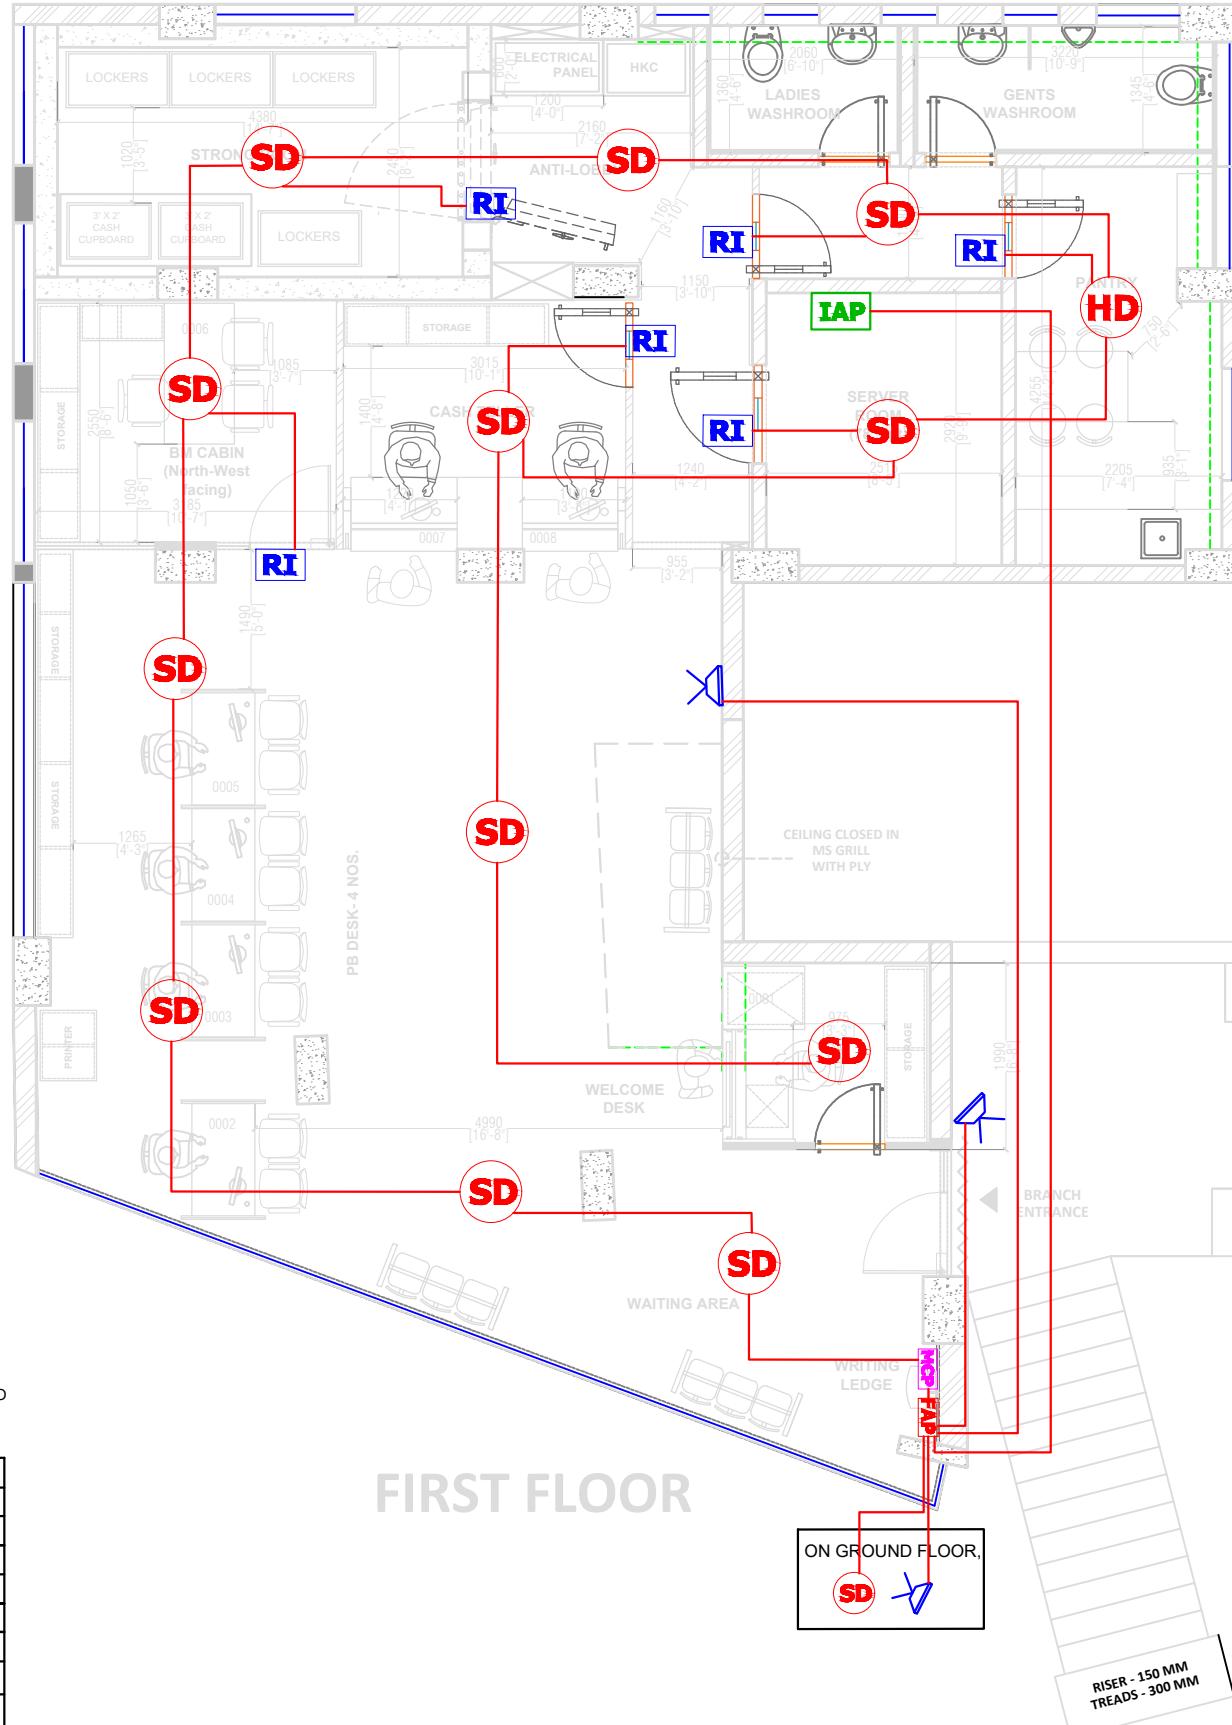

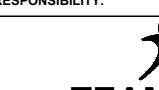CLIENT:	HDFC BANK
PROJECT TYPE:	TIER II-III
GROUND FLOOR SB HT:	2755 MM
GROUND FLOOR BB HT:	2450 MM
1ST FLOOR .SB HT:	2825 MM
1ST FLOOR .BB HT:	2345 MM
DRG TITLE :	PROPOSED PLAN
OPTION :	OPTION 2
DATE :	17-04-25
SCALE :	FIT TO SCALE
DRAWN BY :	SANIYA
CHECKED BY :	ALI
DRG ISSUED FOR :	APPROVAL
 	
NOTE: THIS DRAWING IS THE PROPERTY OF M/s.TEAMSWIFT PROJECTS PVT. LTD. AND IS NOT TO BE REPRODUCED OR HANDED OVER TO A THIRD PARTY OR USE FOR ANY OTHER PURPOSE OTHER THAN FOR WHICH IT IS ISSUED.	
DISCLAIMER: M/s TEAMSWIFT PROJECTS PVT. LTD. IS NOT RESPONSIBLE FOR STATUTORY/GOVT. APPROVALS WHICH SHALL BE THE OWNER'S RESPONSIBILITY.	
 TEAMSWIFT PROJECTS PVT. LTD. A DESIGN - BUILD, FIT - OUT COMPANY	


HDFC BANK DEHU GAON BRANCH, PUNE - PROPOSED PLAN- OPTION 2

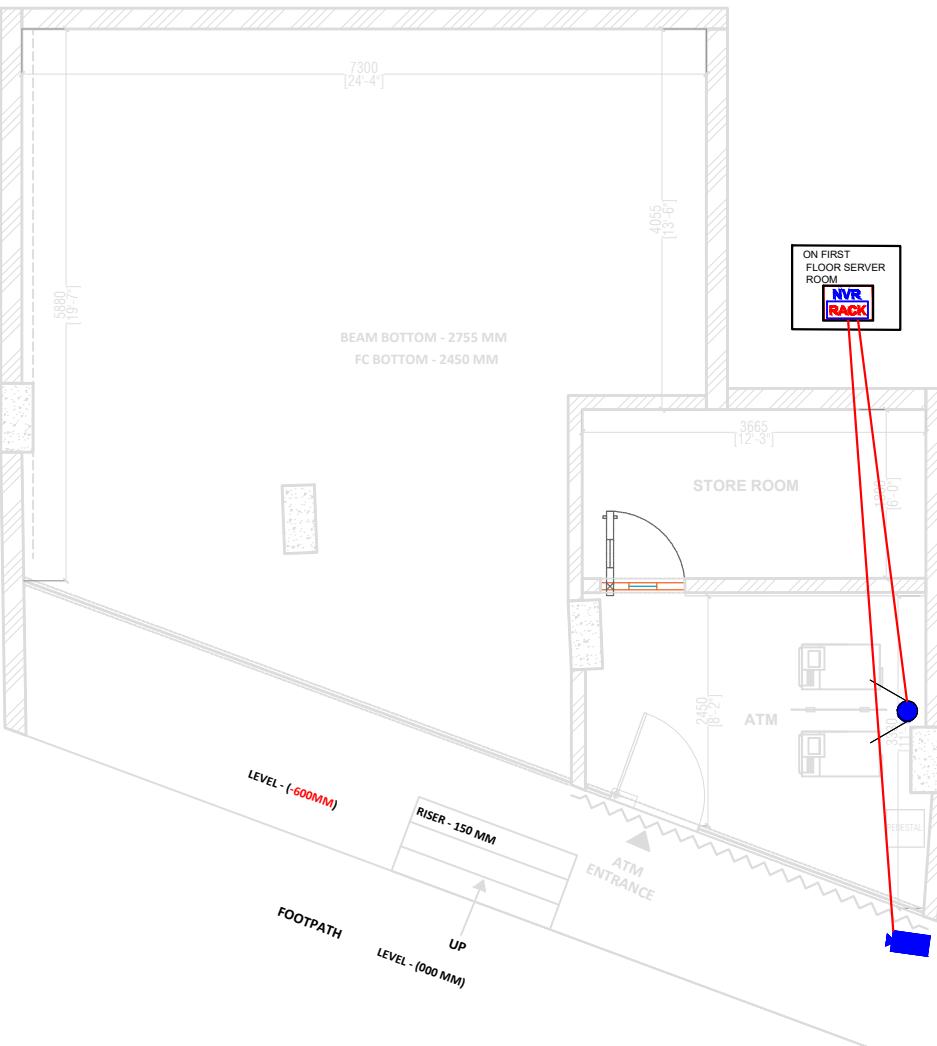

GROUND FLOOR

CLIENT:	HDFC BANK
PROJECT TYPE:	TIER II-III
GROUND FLOOR SB HT:	2755 MM
GROUND FLOOR BB HT:	2450 MM
1ST FLOOR .SB HT:	2825 MM
1ST FLOOR .BB HT:	2345 MM
DRG TITLE :	PROPOSED PLAN
OPTION :	OPTION 2
DATE :	17-04-25
SCALE :	FIT TO SCALE
DRAWN BY :	SANIYA
CHECKED BY :	ALI
DRG ISSUED FOR :	APPROVAL
 	
NOTE: THIS DRAWING IS THE PROPERTY OF M/s. TEAMSWIFT PROJECTS PVT. LTD. AND IS NOT TO BE REPRODUCED OR HANDED OVER TO A THIRD PARTY OR USE FOR ANY OTHER PURPOSE OTHER THAN FOR WHICH IT IS ISSUED.	
DISCLAIMER: M/s. TEAMSWIFT PROJECTS PVT. LTD. IS NOT RESPONSIBLE FOR STATUTORY/GOV'T. APPROVALS WHICH SHALL BE THE OWNER'S RESPONSIBILITY.	
 TEAMSWIFT PROJECTS PVT. LTD. A DESIGN - BUILD, FIT - OUT COMPANY	

HDFC BANK DEHU GAON BRANCH, PUNE - PROPOSED PLAN- OPTION 2

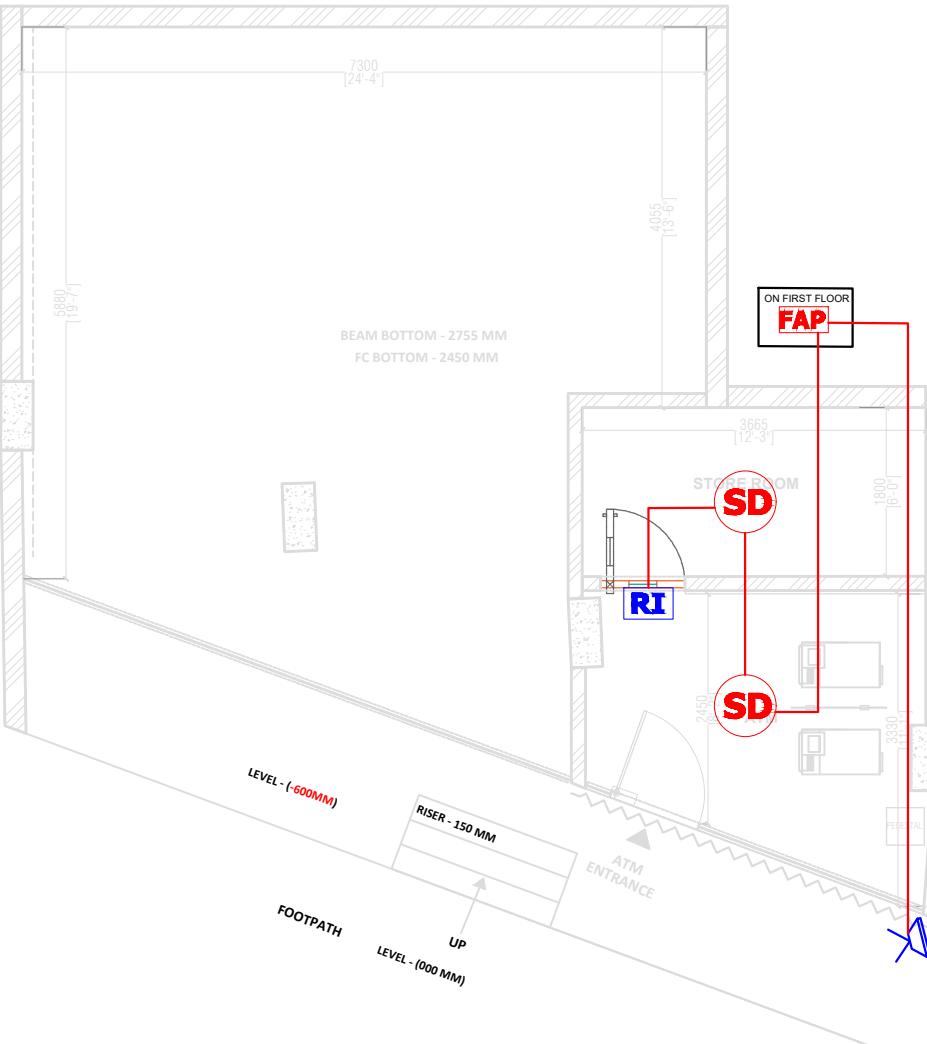


GROUND FLOOR

CLIENT:	HDFC BANK
PROJECT TYPE:	TIER II-III
GROUND FLOOR SB HT:	2755 MM
GROUND FLOOR BB HT:	2450 MM
1ST FLOOR .SB HT:	2825 MM
1ST FLOOR .BB HT:	2345 MM
DRG TITLE :	PROPOSED PLAN
OPTION :	OPTION 2
DATE :	17-04-25
SCALE :	FIT TO SCALE
DRAWN BY :	SANIYA
CHECKED BY :	ALI
DRG ISSUED FOR :	APPROVAL
 	
NOTE: THIS DRAWING IS THE PROPERTY OF M/s. TEAMSWIFT PROJECTS PVT. LTD. AND IS NOT TO BE REPRODUCED OR HANDED OVER TO A THIRD PARTY OR USE FOR ANY OTHER PURPOSE OTHER THAN FOR WHICH IT IS ISSUED.	
DISCLAIMER: M/s. TEAMSWIFT PROJECTS PVT. LTD. IS NOT RESPONSIBLE FOR STATUTORY/GOV'T. APPROVALS WHICH SHALL BE THE OWNER'S RESPONSIBILITY.	
 TEAMSWIFT PROJECTS PVT. LTD. A DESIGN - BUILD, FIT - OUT COMPANY	


HDFC BANK DEHU GAON BRANCH, PUNE - PROPOSED PLAN- OPTION 2

CLIENT:	HDFC BANK
PROJECT TYPE:	TIER II-III
GROUND FLOOR SB HT:	2755 MM
GROUND FLOOR BB HT:	2450 MM
1ST FLOOR .SB HT:	2825 MM
1ST FLOOR .BB HT:	2345 MM
DRG TITLE :	PROPOSED PLAN
OPTION :	OPTION 2
DATE :	17-04-25
SCALE :	FIT TO SCALE
DRAWN BY :	SANIYA
CHECKED BY :	ALI
DRG ISSUED FOR :	APPROVAL
 	
NOTE: THIS DRAWING IS THE PROPERTY OF M/s. TEAMSWIFT PROJECTS PVT. LTD. AND IS NOT TO BE REPRODUCED OR HANDED OVER TO A THIRD PARTY OR USE FOR ANY OTHER PURPOSE OTHER THAN FOR WHICH IT IS ISSUED.	
DISCLAIMER: M/s. TEAMSWIFT PROJECTS PVT. LTD. IS NOT RESPONSIBLE FOR STATUTORY/GOV'T. APPROVALS WHICH SHALL BE THE OWNER'S RESPONSIBILITY.	
 TEAMSWIFT PROJECTS PVT. LTD. A DESIGN - BUILD, FIT - OUT COMPANY	

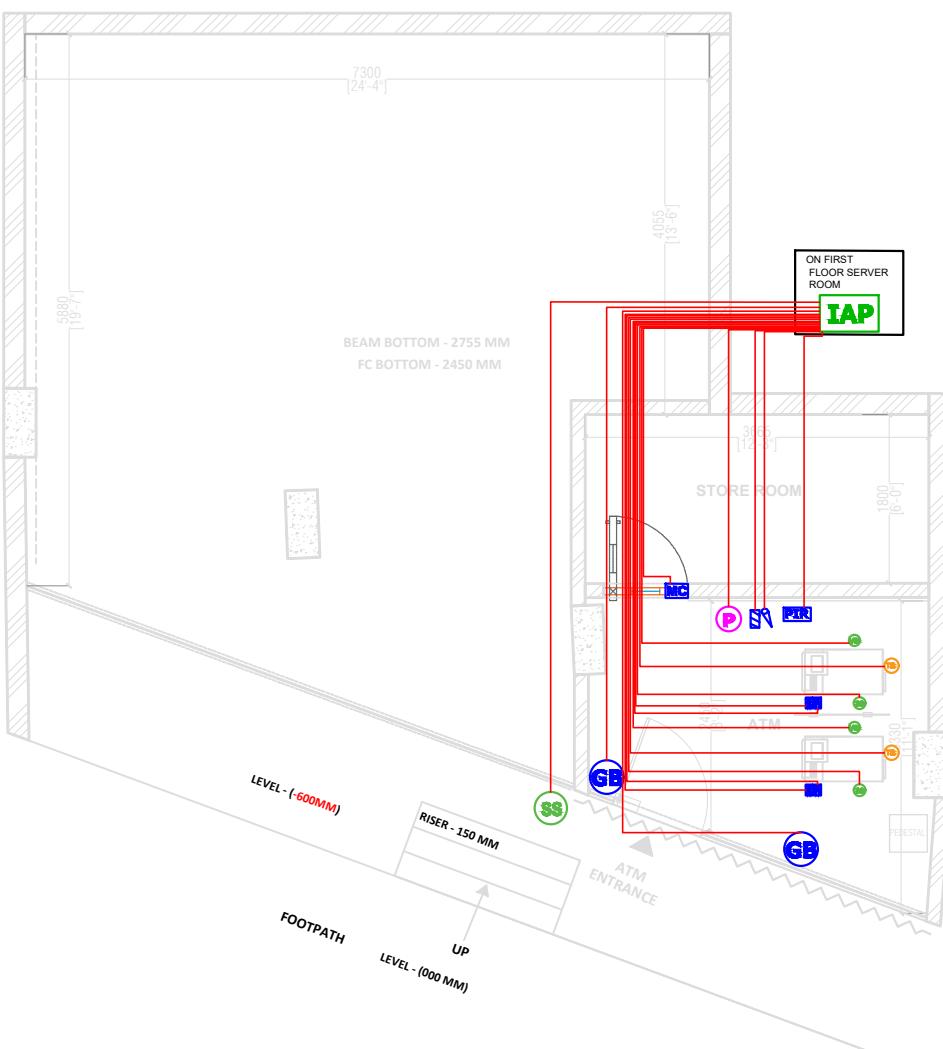


GROUND FLOOR


HDFC BANK DEHU GAON BRANCH, PUNE - PROPOSED PLAN- OPTION 2

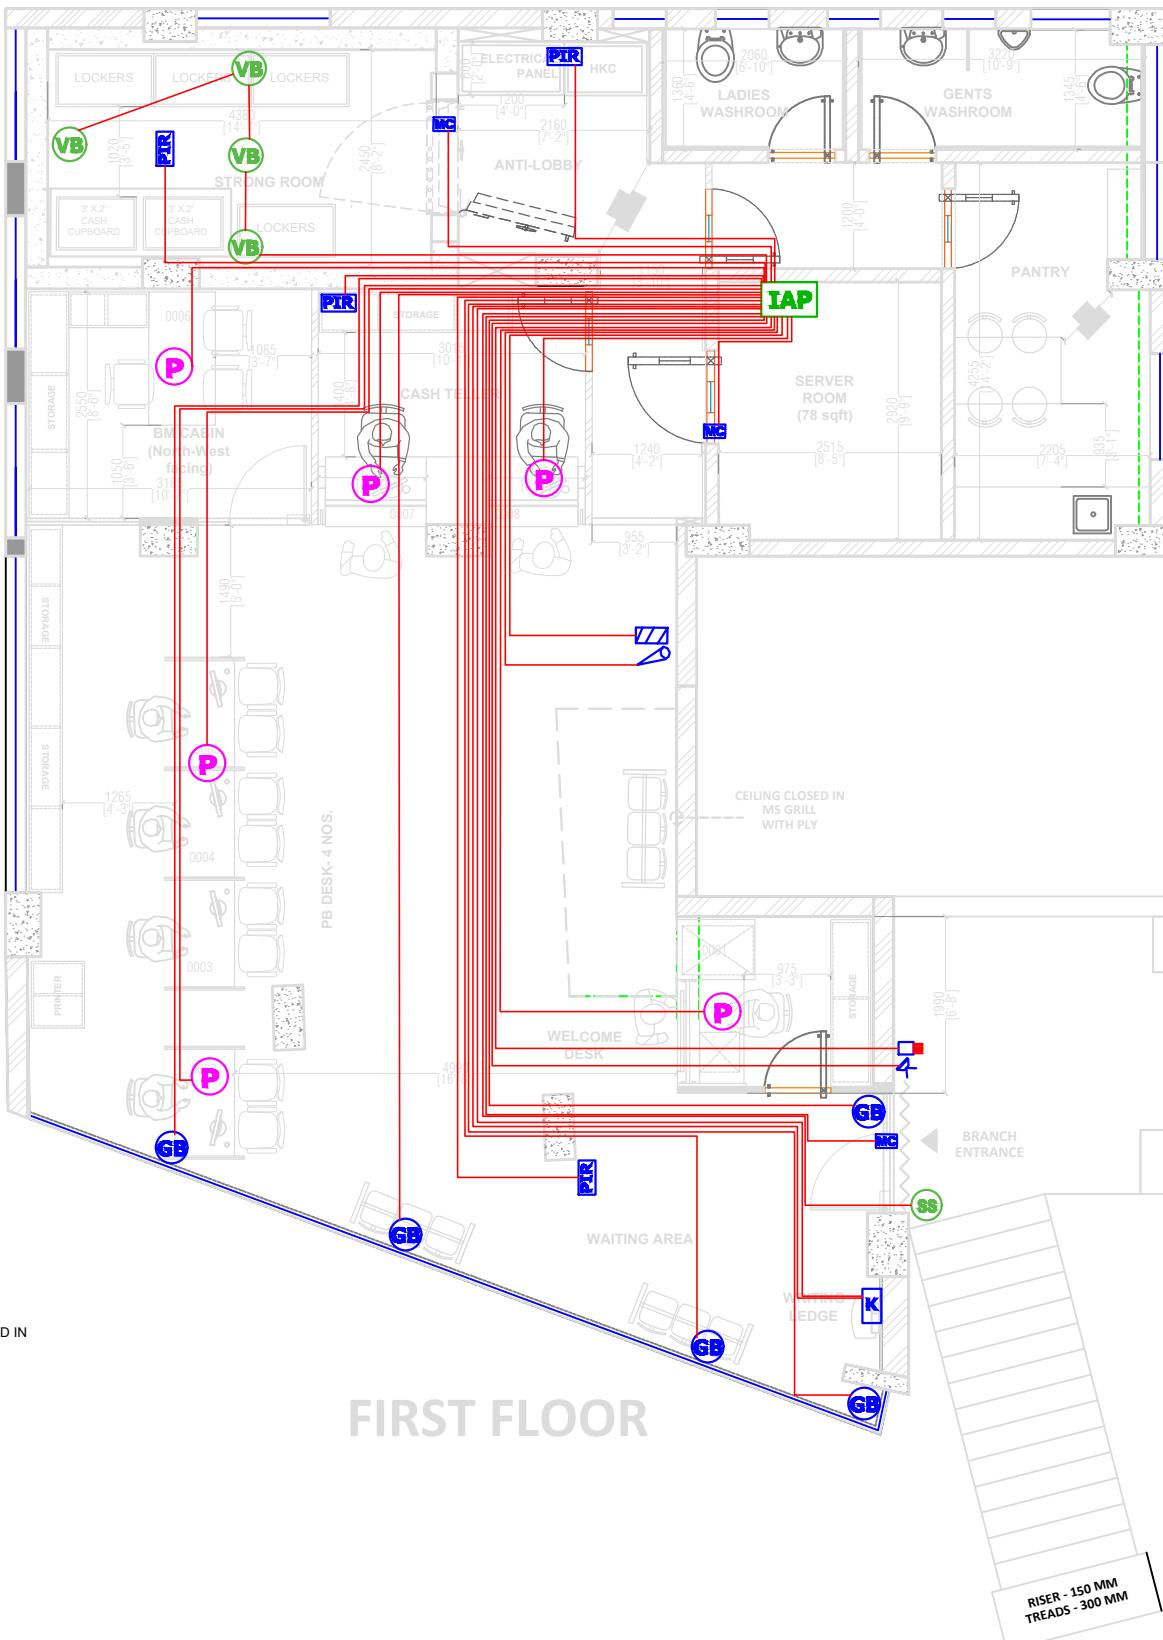


CLIENT:	HDFC BANK
PROJECT TYPE:	TIER II-III
GROUND FLOOR SB HT:	2755 MM
GROUND FLOOR BB HT:	2450 MM
1ST FLOOR .SB HT:	2825 MM
1ST FLOOR .BB HT:	2345 MM
DRG TITLE :	PROPOSED PLAN
OPTION :	OPTION 2
DATE :	17-04-25
SCALE :	FIT TO SCALE
DRAWN BY :	SANIYA
CHECKED BY :	ALI
DRG ISSUED FOR :	APPROVAL
NOTE: THIS DRAWING IS THE PROPERTY OF M/s TEAMSWIFT PROJECTS PVT. LTD. AND IS NOT TO BE REPRODUCED OR HANDED OVER TO A THIRD PARTY OR USE FOR ANY OTHER PURPOSE OTHER THAN FOR WHICH IT IS ISSUED.	
DISCLAIMER: M/s TEAMSWIFT PROJECTS PVT. LTD. IS NOT RESPONSIBLE FOR STATUTORY/GOV'T APPROVALS WHICH SHALL BE THE OWNER'S RESPONSIBILITY.	
TEAMSWIFT PROJECTS PVT. LTD. A DESIGN - BUILD, FIT - OUT COMPANY	


HDFC BANK DEHU GAON BRANCH, PUNE - RACEWAY - LAYOUT

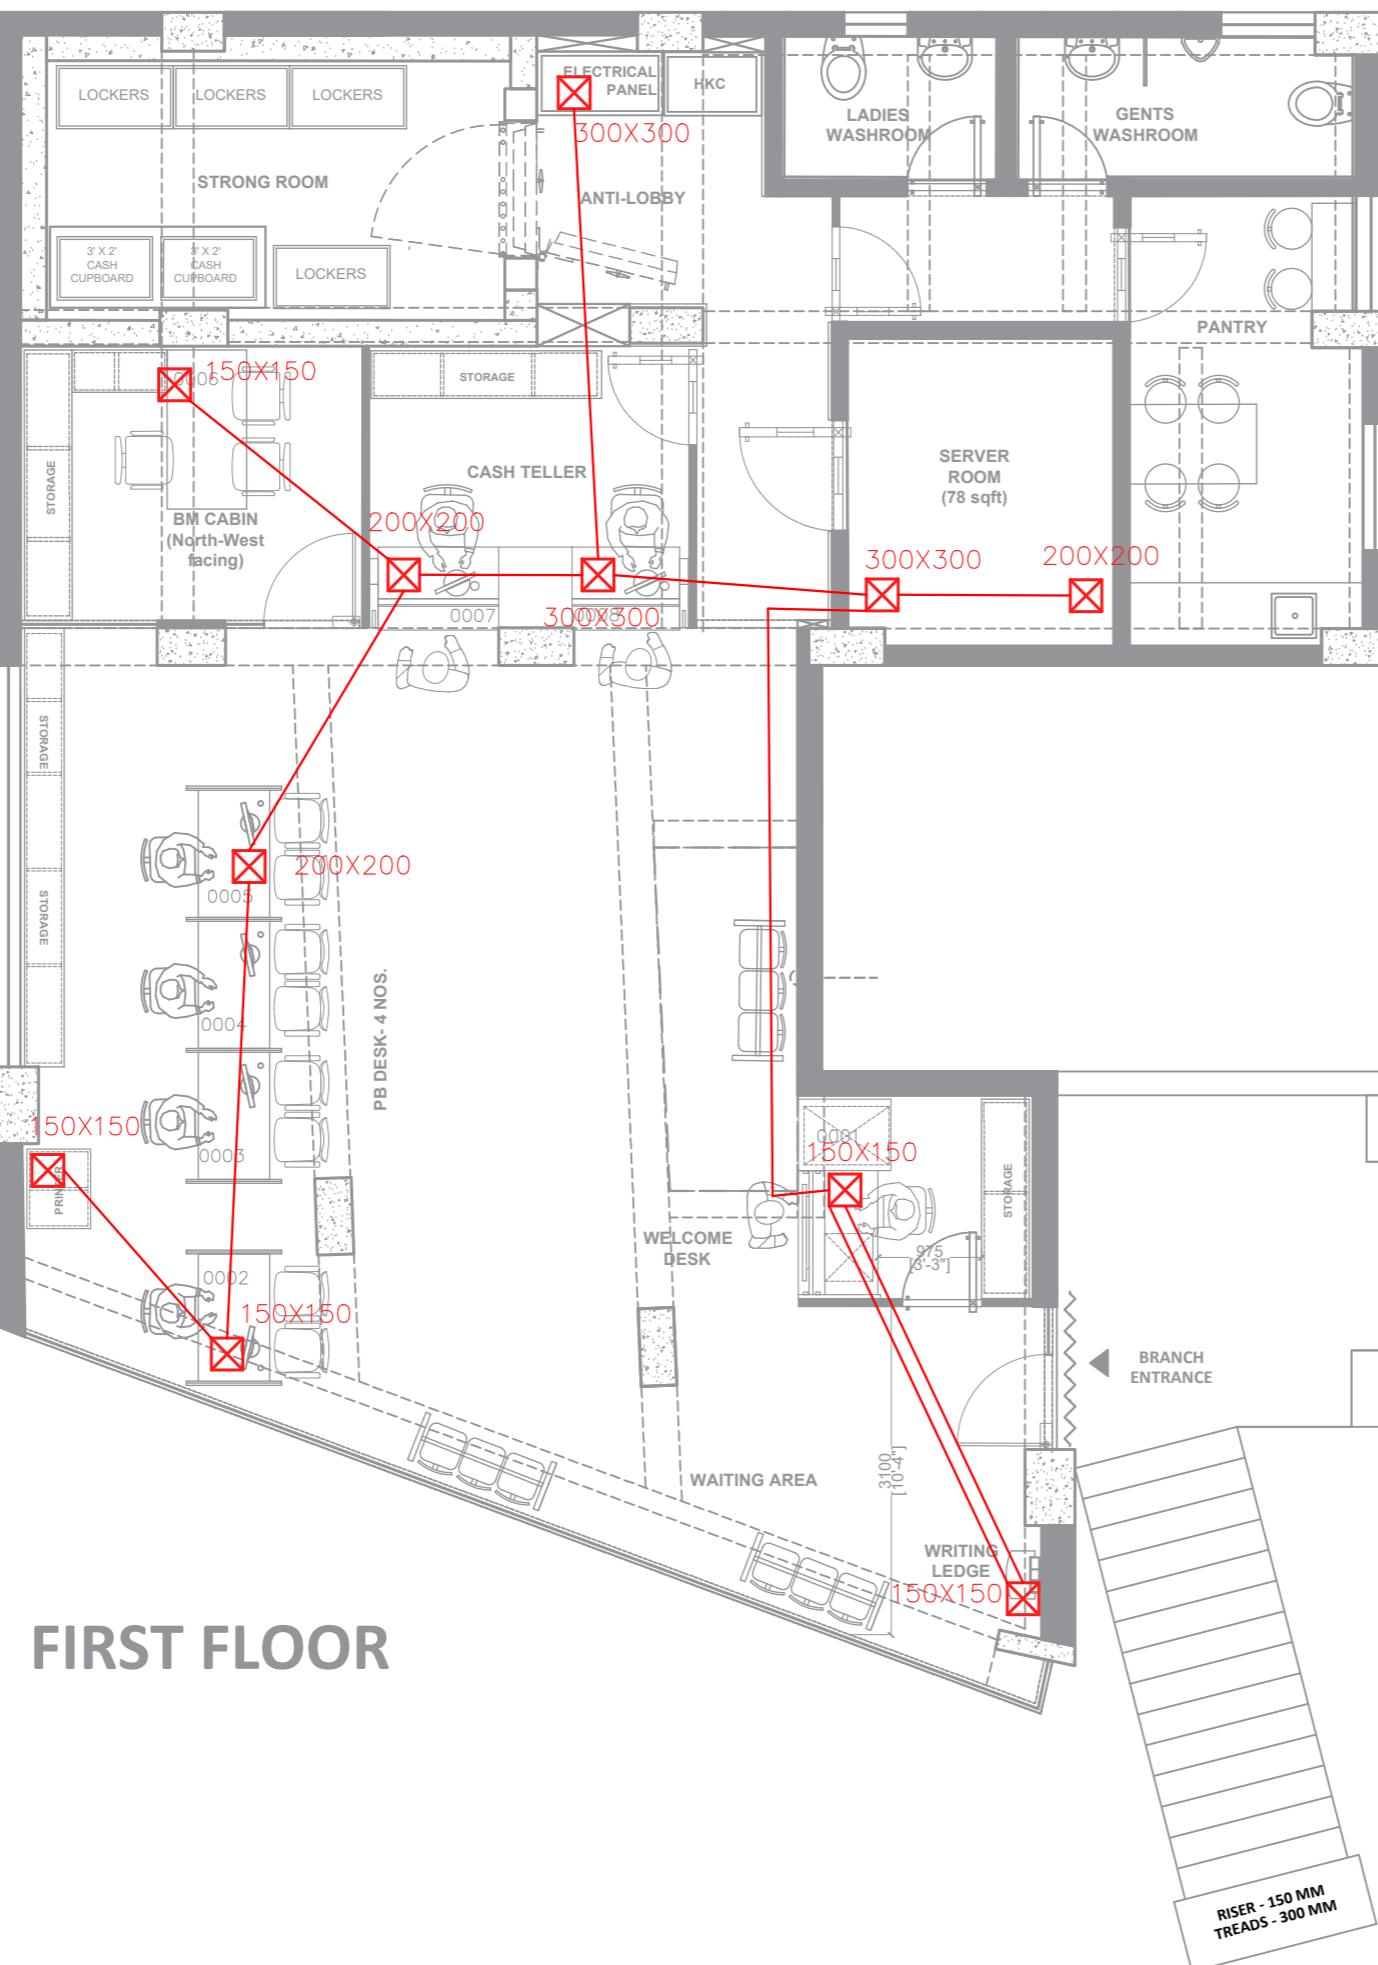

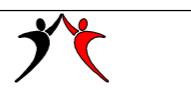CLIENT:	HDFC BANK
PROJECT TYPE:	II-III
GROUND FLOOR SB HT:	2755 MM
GROUND FLOOR BB HT:	2450 MM
1ST FLOOR .SB HT:	2825 MM
1ST FLOOR .BB HT:	2345 MM
DRG TITLE :	RACEWAY - LAYOUT
OPTION :	
DATE :	11-08-25
SCALE :	FIT TO SCALE
DRAWN BY :	JAMILA
CHECKED BY :	ALI
DRG ISSUED FOR :	APPROVAL
 	
NOTE: THIS DRAWING IS THE PROPERTY OF M/s TEAMSWIFT PROJECTS PVT. LTD. AND IS NOT TO BE REPRODUCED OR HANDED OVER TO A THIRD PARTY OR USE FOR ANY OTHER PURPOSE OTHER THAN FOR WHICH IT IS ISSUED.	
DISCLAIMER: M/s TEAMSWIFT PROJECTS PVT. LTD. IS NOT RESPONSIBLE FOR STATUTORY/GOV'T APPROVALS WHICH SHALL BE THE OWNER'S RESPONSIBILITY.	
 TEAMSWIFT PROJECTS PVT. LTD. A DESIGN - BUILD, FIT - OUT COMPANY	

HDFC BANK DEHU GAON BRANCH, PUNE - PROPOSED PLAN- OPTION 2

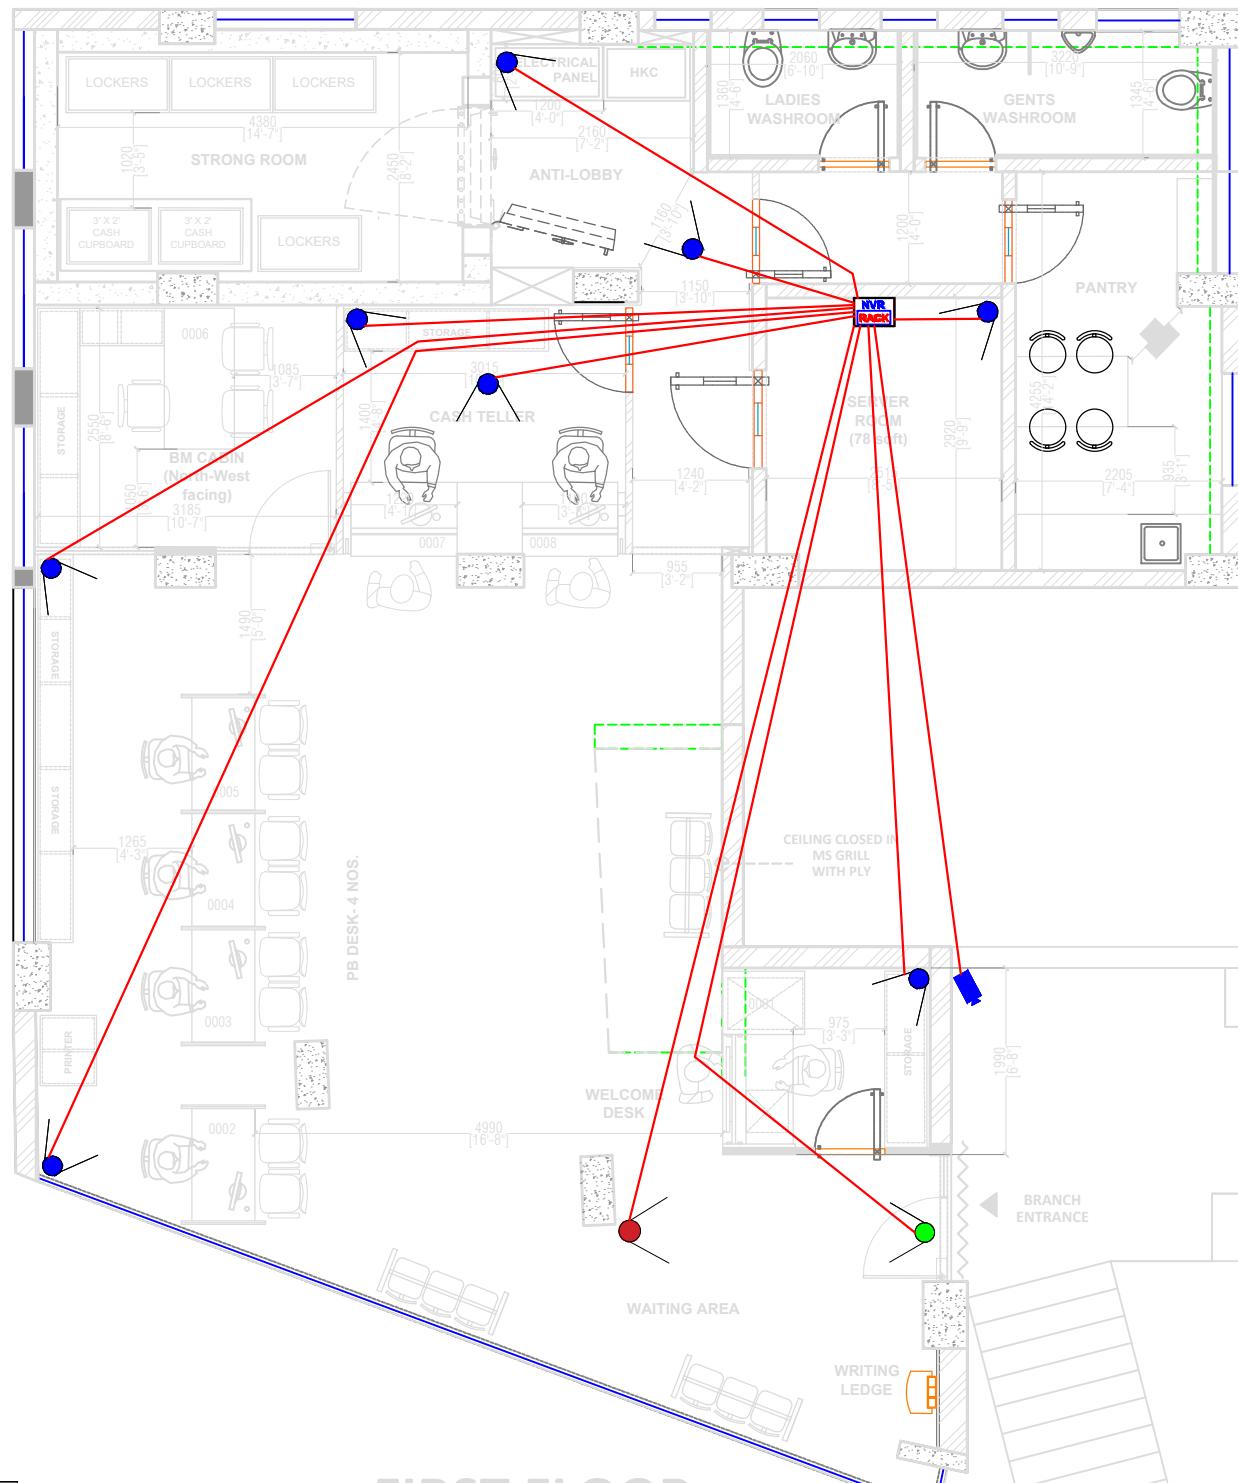

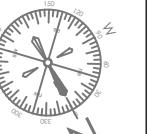CLIENT:	HDFC BANK
PROJECT TYPE:	TIER II-III
GROUND FLOOR SB HT:	2755 MM
GROUND FLOOR BB HT:	2450 MM
1ST FLOOR .SB HT:	2825 MM
1ST FLOOR .BB HT:	2345 MM
DRG TITLE :	PROPOSED PLAN
OPTION :	OPTION 2
DATE :	17-04-25
SCALE :	FIT TO SCALE
DRAWN BY :	SANIYA
CHECKED BY :	ALI
DRG ISSUED FOR :	APPROVAL
 	
NOTE: THIS DRAWING IS THE PROPERTY OF M/s.TEAMSWIFT PROJECTS PVT. LTD. AND IS NOT TO BE REPRODUCED OR HANDED OVER TO A THIRD PARTY OR USE FOR ANY OTHER PURPOSE OTHER THAN FOR WHICH IT IS ISSUED.	
DISCLAIMER: M/s TEAMSWIFT PROJECTS PVT. LTD. IS NOT RESPONSIBLE FOR STATUTORY/GOVT. APPROVALS WHICH SHALL BE THE OWNER'S RESPONSIBILITY.	
 TEAMSWIFT PROJECTS PVT. LTD. A DESIGN - BUILD, FIT - OUT COMPANY	