

TOTAL HT 9'-8" FLOOR TO BEAM HT 8'-2"

TOTAL AREA - 1233.8 SET

# AS BUILT INTERIOR LAYOUT OF HDFC BANK BARSHI ROAD LATUR FIRST FLOOR.


DWG : 16

DATE : 11.04.2025

SCALE:- NTS



 Aryan Interiors  
B-1004, 10th Floor, cello Triumph, I.B.Patel Road,  
Goregoan (East), Mumbai - 400 063.  
Tel.: + 91 222 685 2969  
E-mail: [info@aryaninteriors.com](mailto:info@aryaninteriors.com)

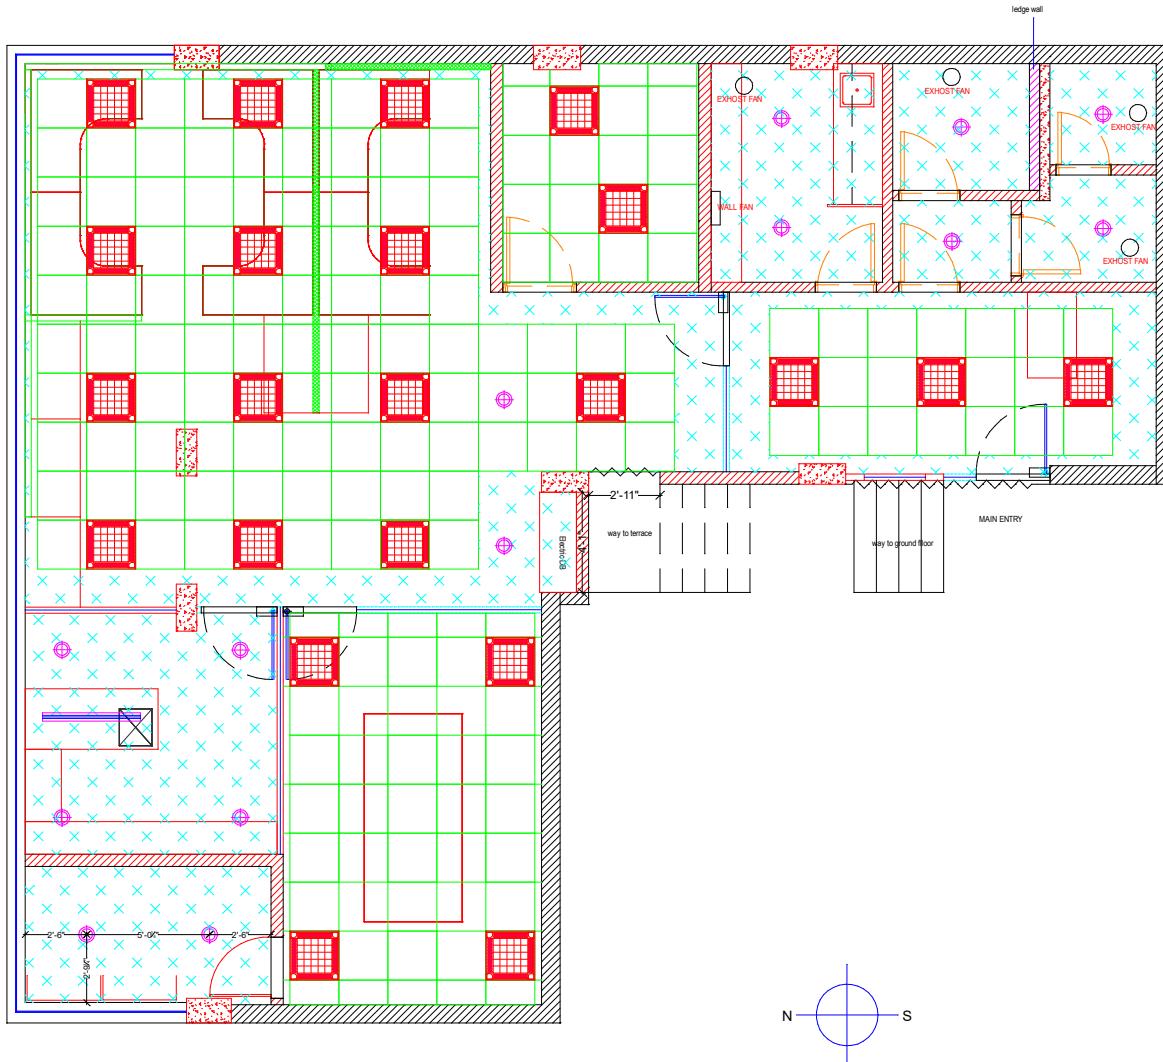

TOTAL HT 9'-8" FLOOR TO BEAM HT 8'-2"  
 TOTAL AREA - 1233.8 SFT.


**AS BUILT FALSE CEILING LAYOUT OF  
 HDFC BANK BARSHI ROAD LATUR  
 FIRST FLOOR.**

DWG : 16

DATE : 11.04.2025

SCALE:- NTS

 **Aryan Interiors**  
 B-1004, 10th Floor, cello Triumph, I.B.Patel Road,  
 Goregaon (East), Mumbai - 400 063.  
 Tel.: + 91 222 685 2969  
 E-mail: info@aryaninteriors.com

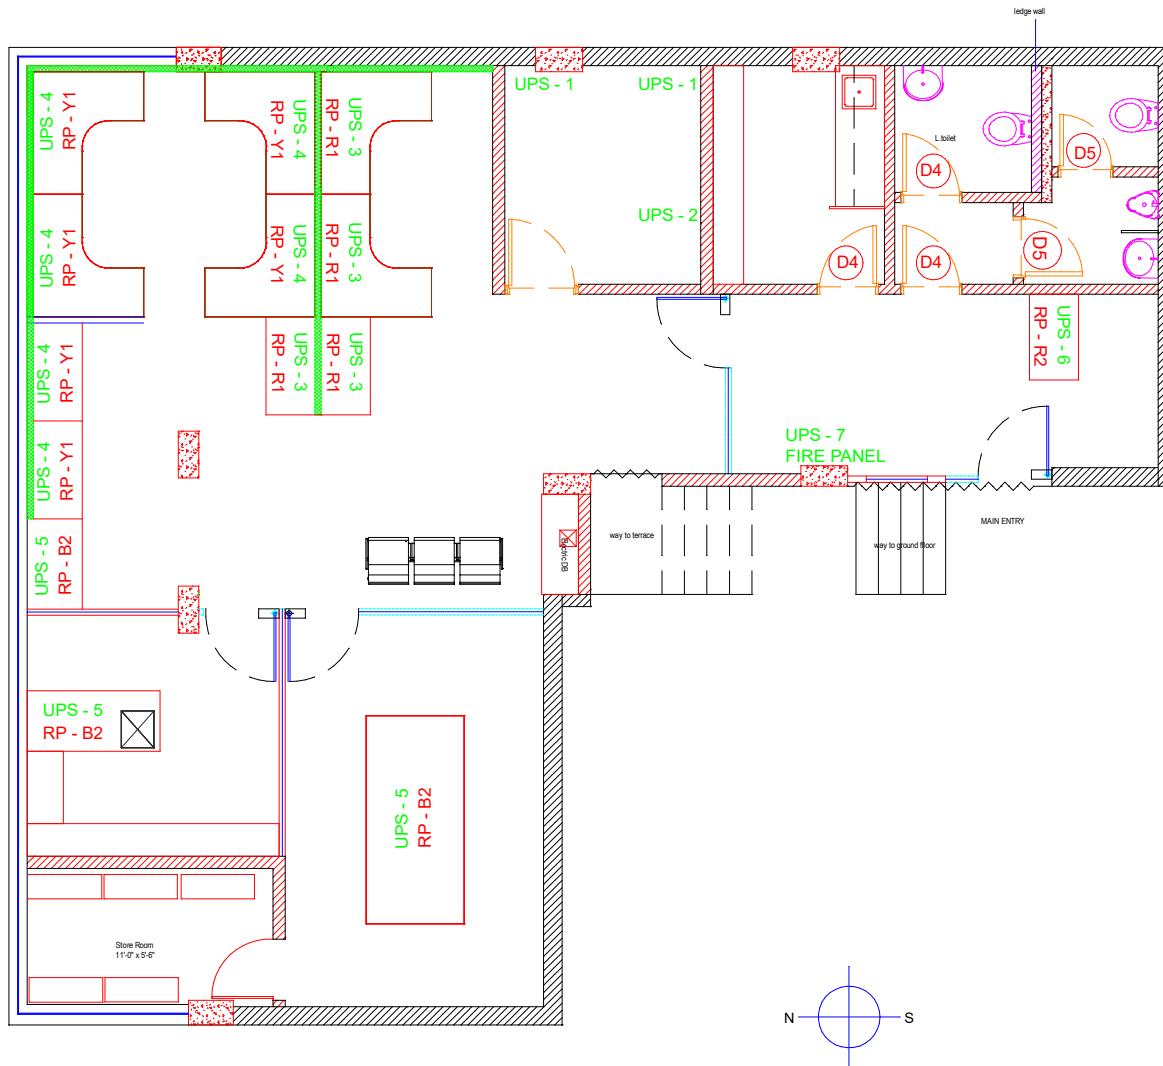

TOTAL HT 9'-8"	FLOOR TO BEAM HT 8'-2"
TOTAL AREA - 1233.8 SFT.	

## AS BUILT UPS & ROWPOWER LAYOUT OF HDFC BANK BARSHI ROAD LATUR FIRST FLOOR.


DWG : 16

DATE : 11.04.2025

SCALE:- NTS



 **Aryan Interiors**  
B-1004,10th Floor,cello Triumph, I.B.Patel Road,  
Goregoan (East), Mumbai - 400 063.  
Tel.: + 91 222 685 2969  
E-mail: [info@aryaninteriors.com](mailto:info@aryaninteriors.com)

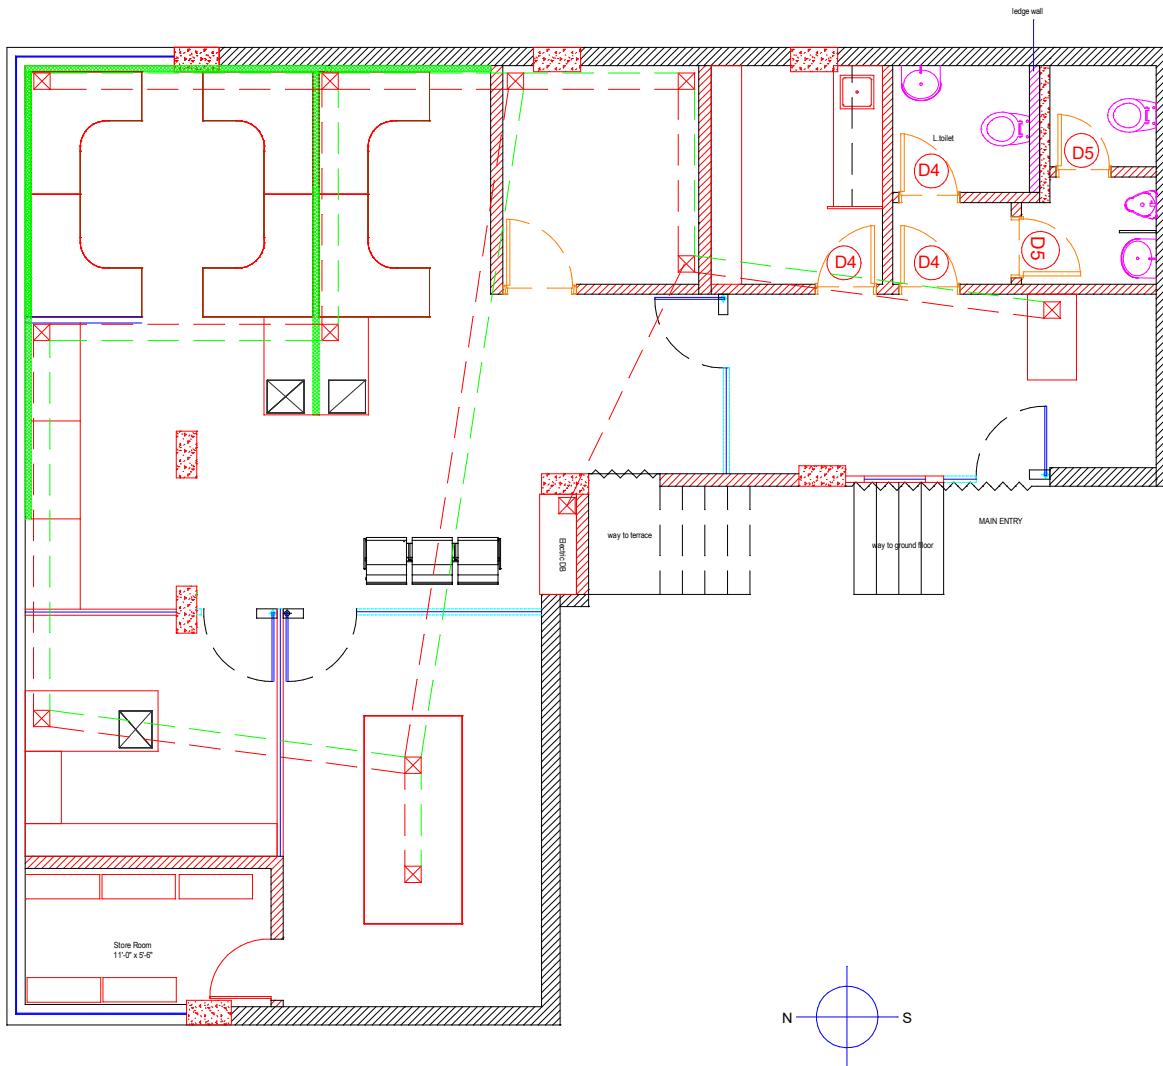


TOTAL HT 9'-8" FLOOR TO BEAM HT 8'-2"  
TOTAL AREA - 1233.8 SFT.

AS BUILT RACEWAY LAYOUT OF HDFC BANK  
BARSHI ROAD LATUR FIRST FLOOR.

DWG : 16

DATE : 11.04.2025

SCALE:- NTS

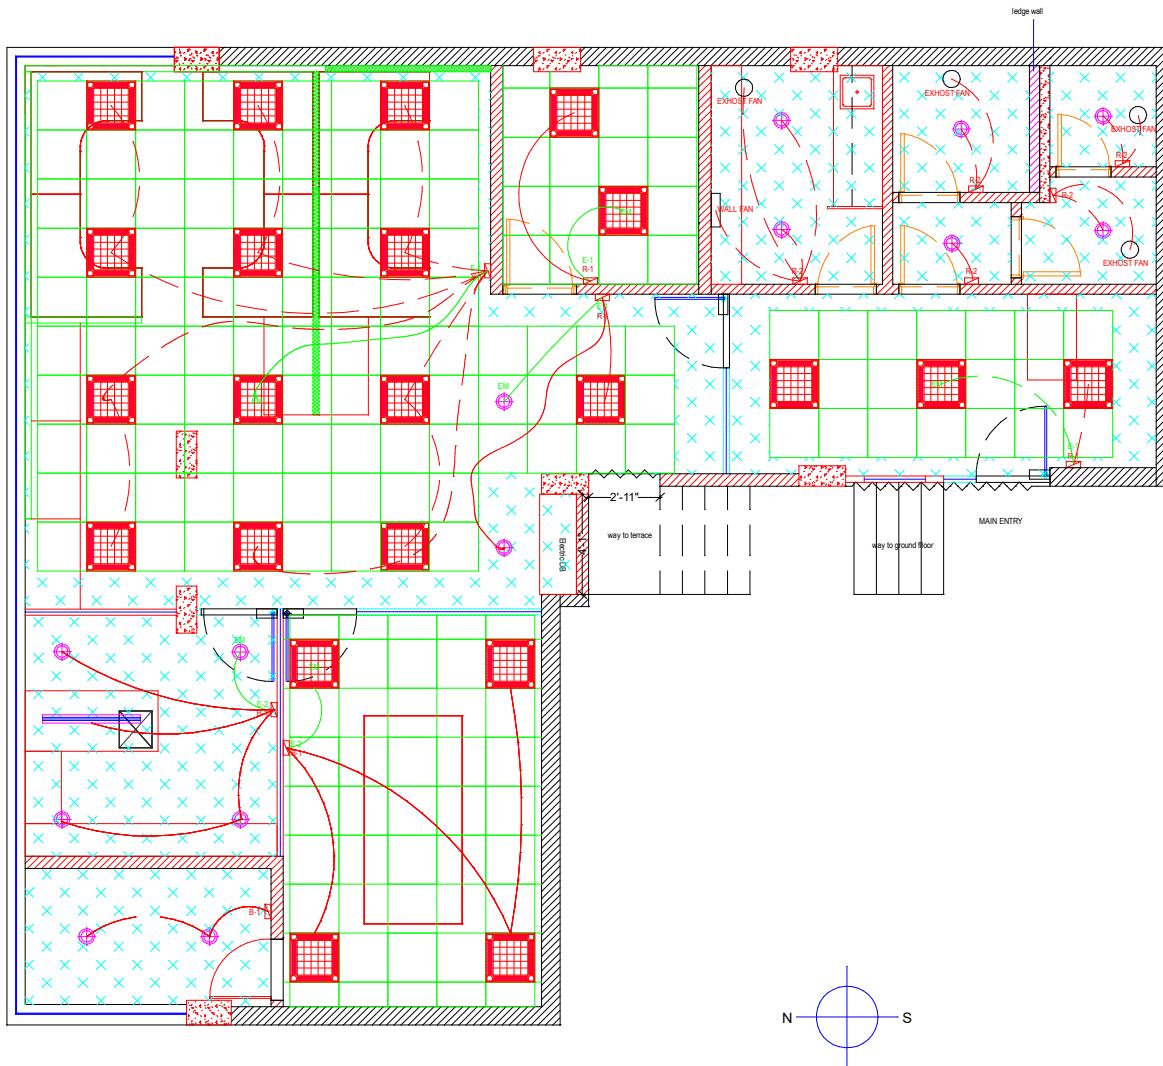

TOTAL HT 9'-8" | FLOOR TO BEAM HT 8'-2"  
TOTAL AREA - 1233.8 SFT.

AS BUILT LIGHTING LOOPING LAYOUT OF  
HDFC BANK BARSHI ROAD LATUR FIRST  
FLOOR.


DWG : 16

DATE : 11.04.2025

SCALE:- NTS

 **Aryan Interiors**  
B-1004, 10th Floor, cello Triumph, I.B.Patel Road,  
Goregoan (East), Mumbai - 400 063.  
Tel.: + 91 222 685 2969  
E-mail: info@aryaninteriors.com

# UPS DB 16 WAY SPN

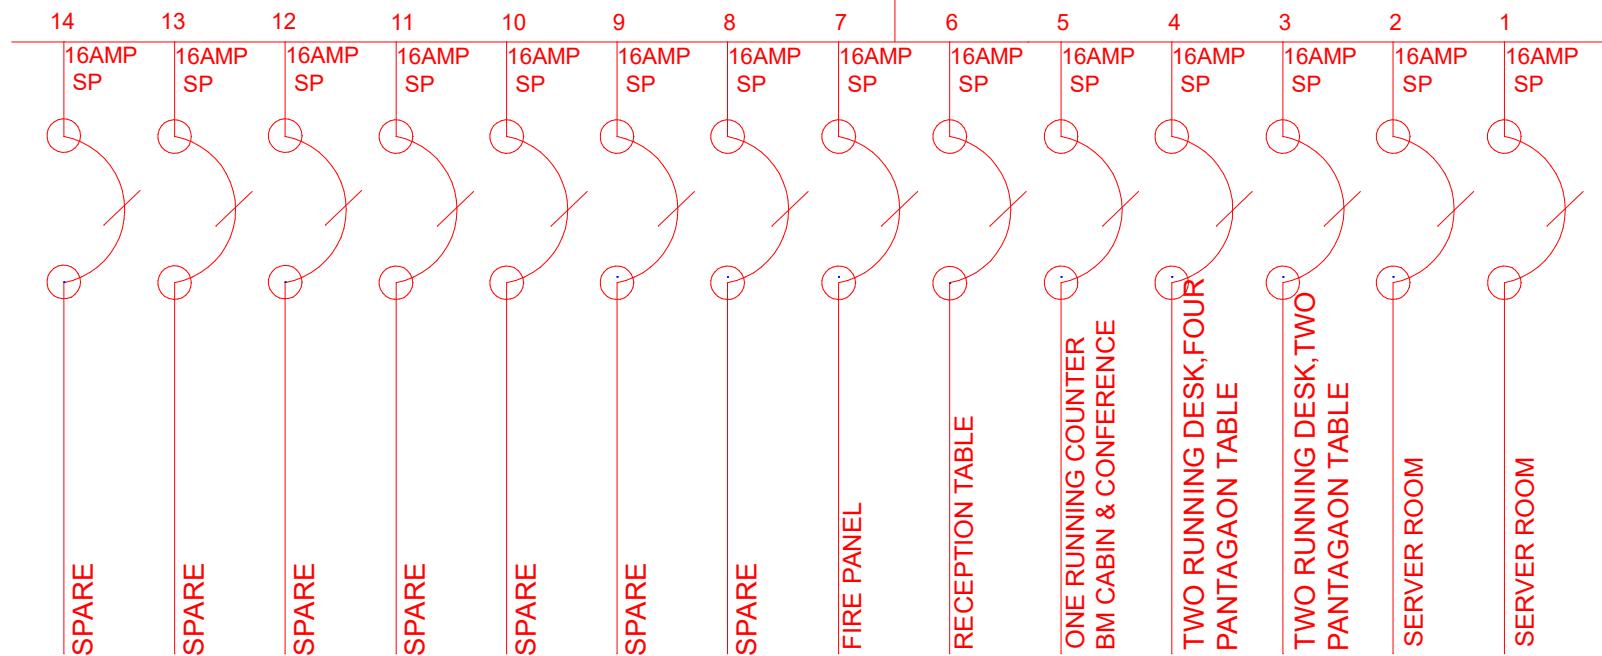

AS BUILT UPS DB SLD LAYOUT FOR HDFC BANK  
BARSHI ROAD LATUR FIRST FLOOR.


Opt. No :

Date : 28 -03 - 2025

Scale No : NTS


# EMERGENCY LIDHTING DB

16 WAY SPN

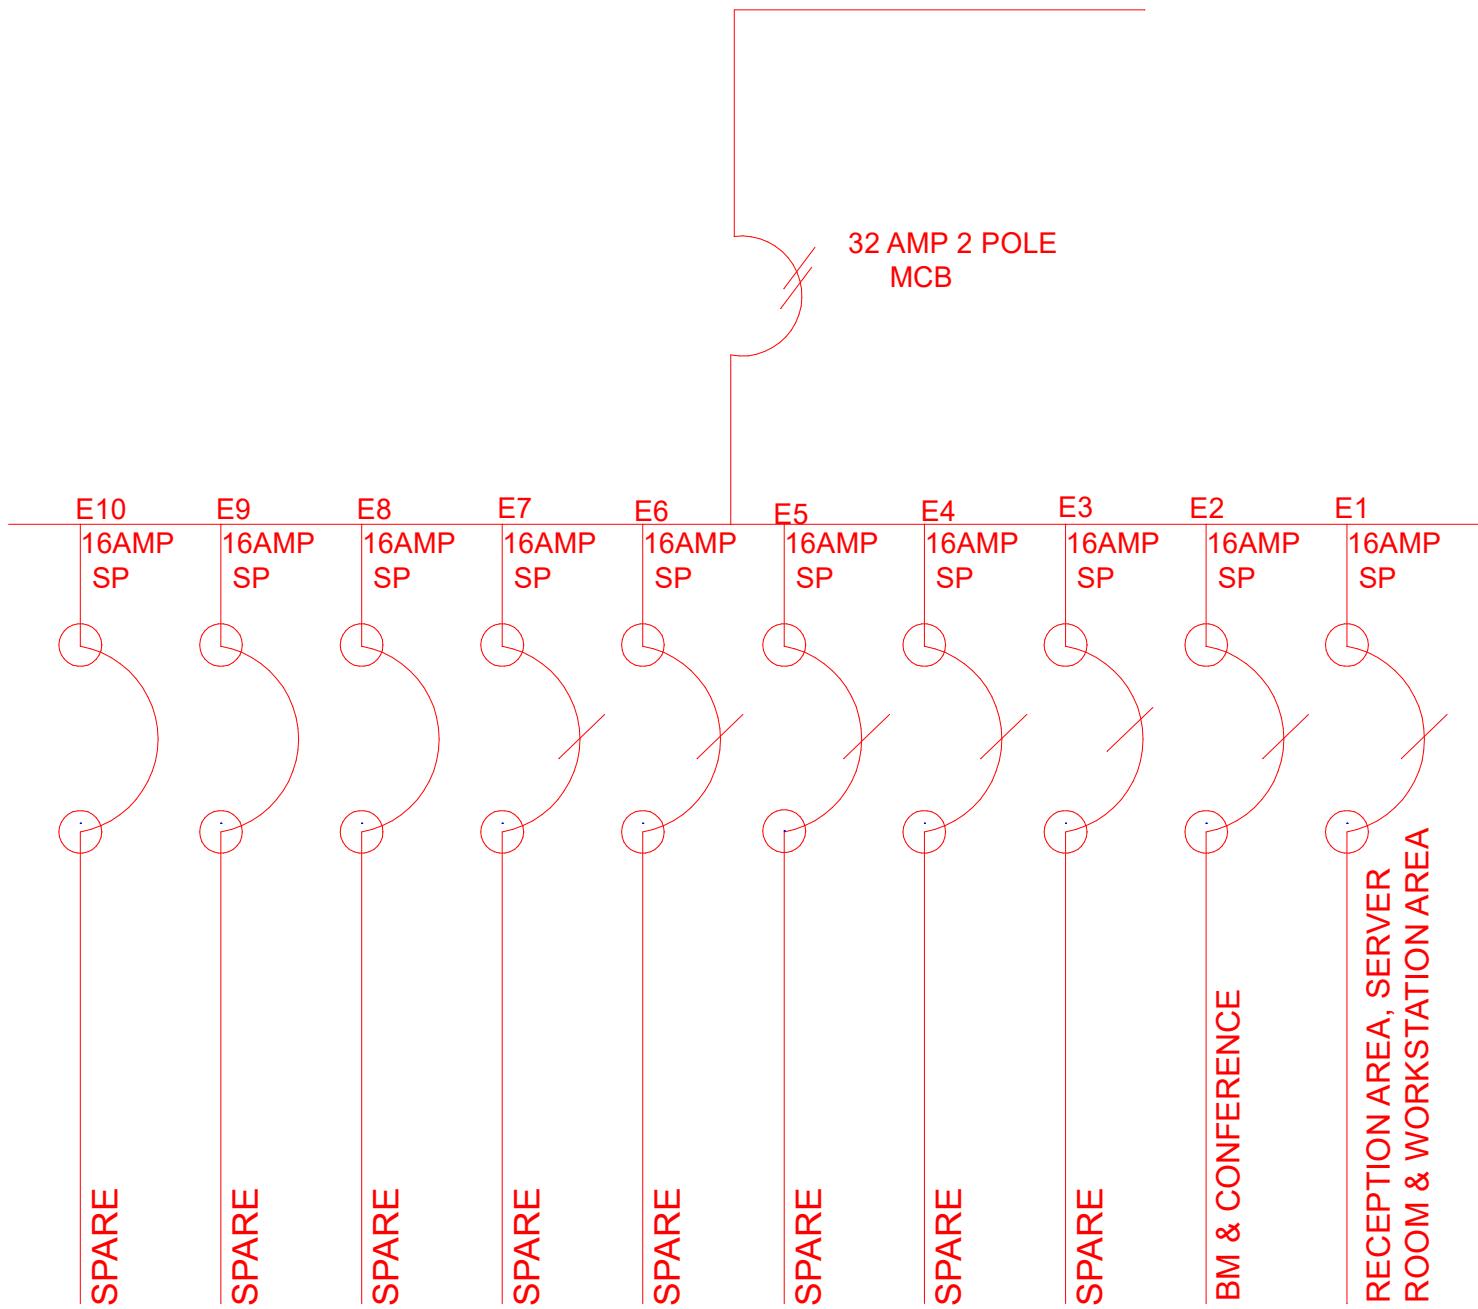

# LIGHTING DB

6 WAY TPN

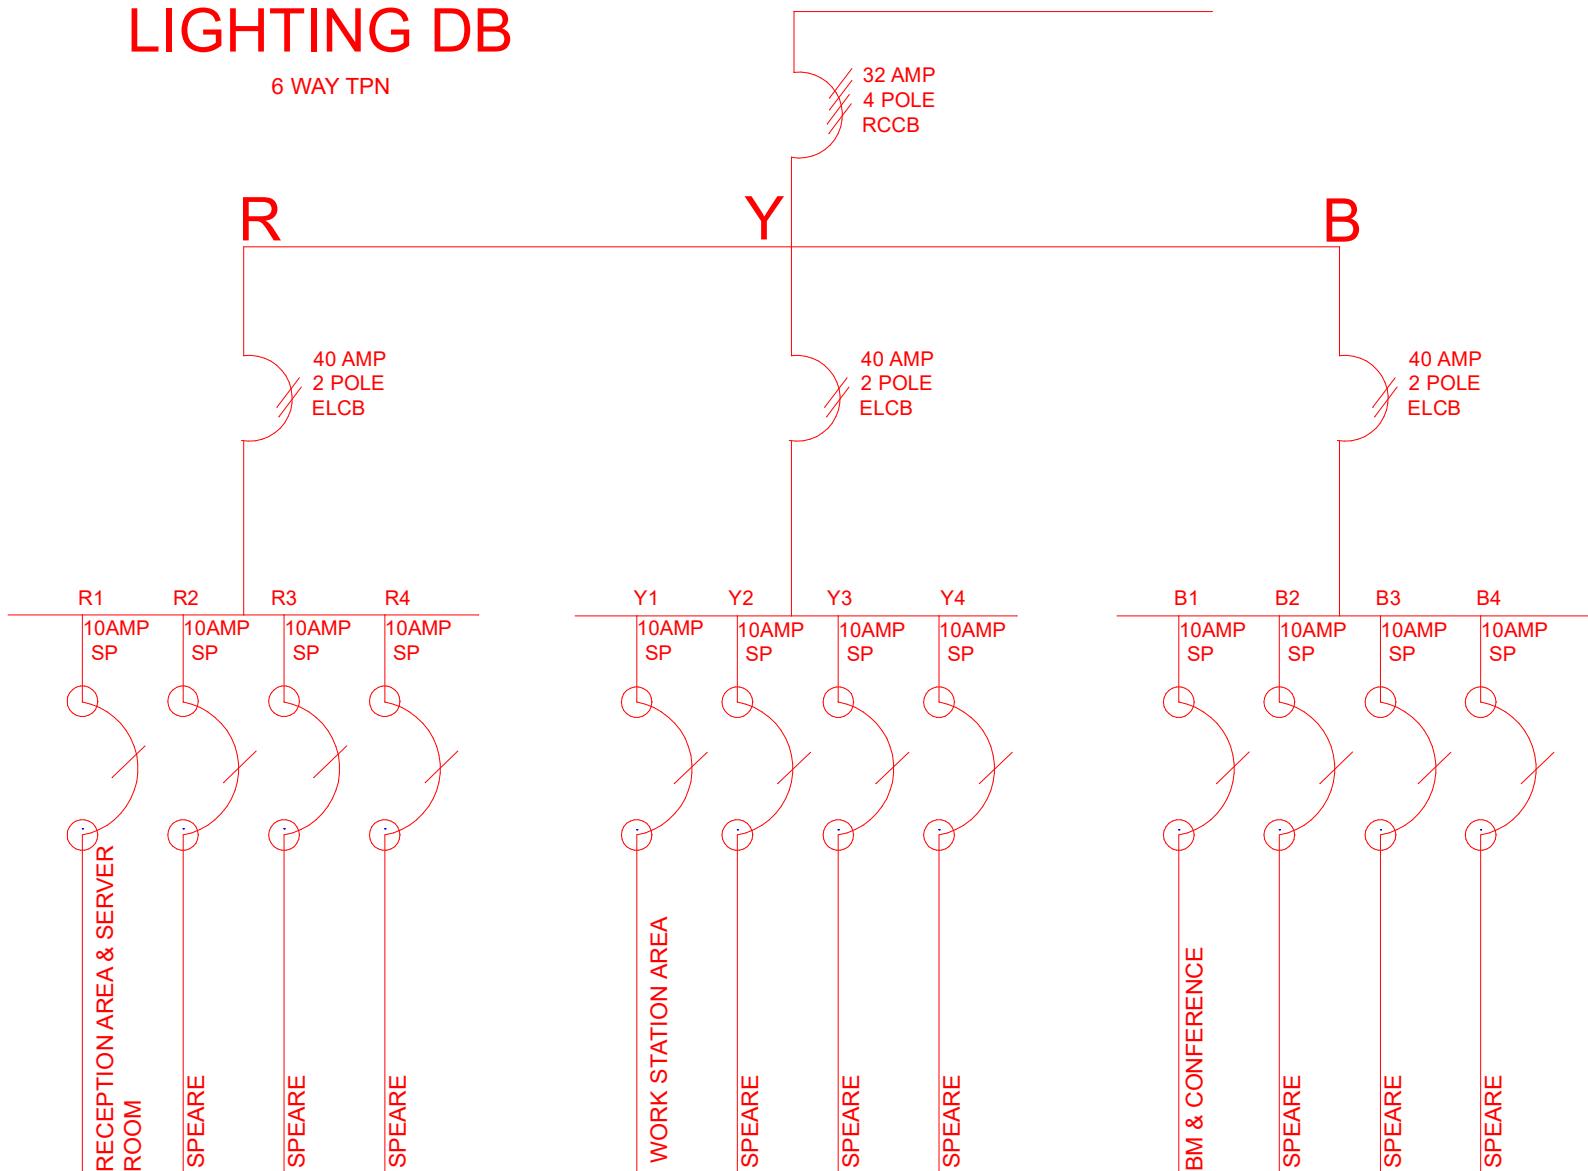

AS BUILT LIGHTING DB SLD LAYOUT FOR HDFC BANK  
BARSHI ROAD LATUR FIRST FLOOR.


Opt. No :

Date : 28 -03 - 2025

Scale No : NTS

## ROW POWER DB

6 WAY TPN

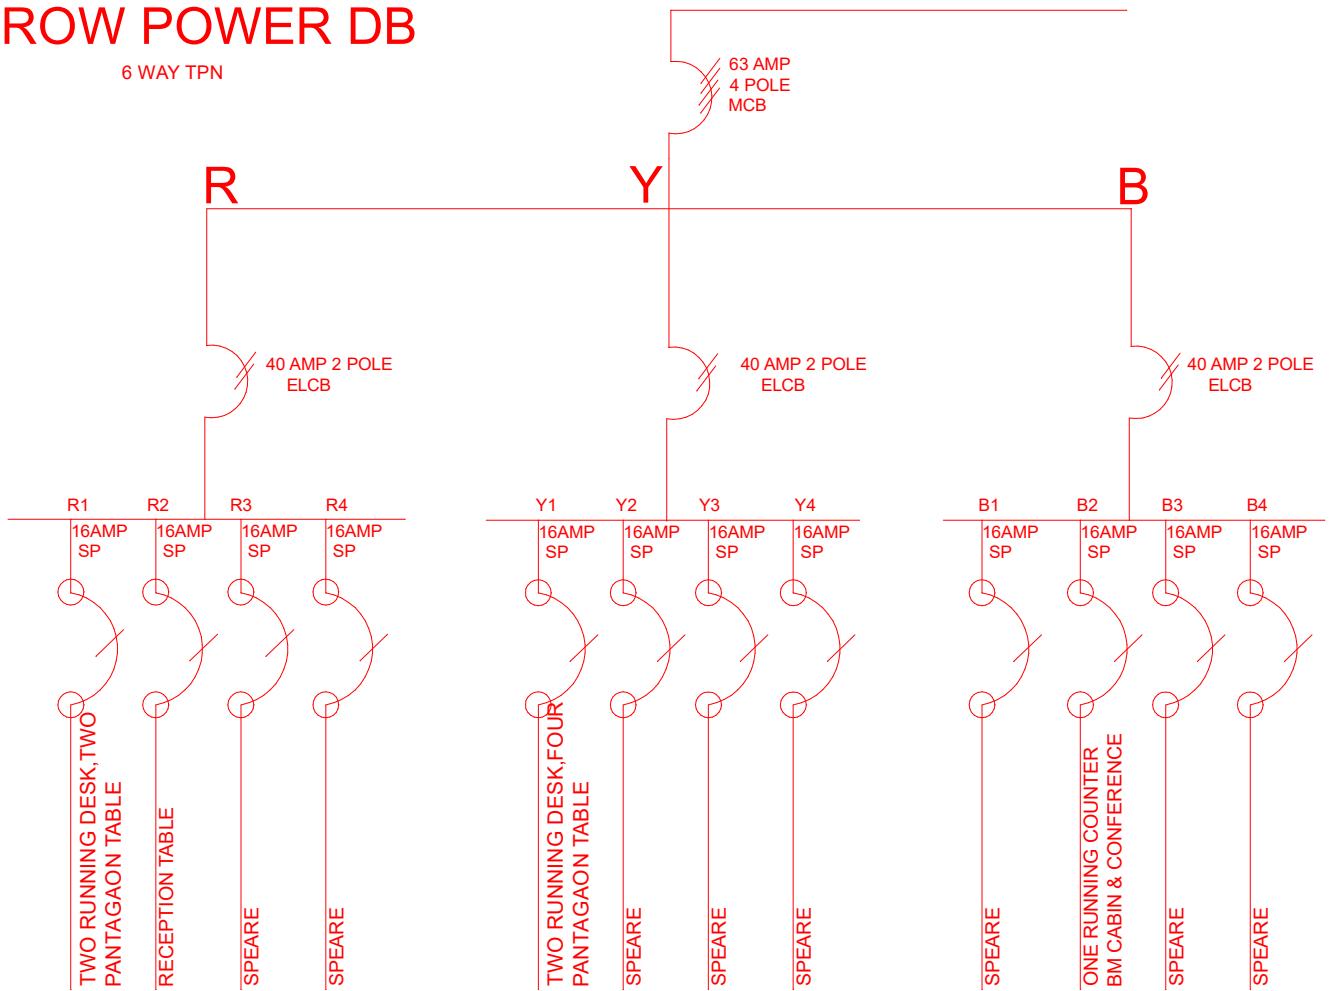

AS BUILT ROW POWER DB SLD LAYOUT FOR HDFC  
BANK BARSHI ROAD LATUR FIRST FLOOR.

Opt. No :

Date : 28 -03 - 2025

Scale No : NTS

 **Aryan Interiors**  
B-1004, 10th Floor, Cello Triumph, I.B.Patel Road,  
Goregoan (East), Mumbai - 400 063.  
Tel.: + 91 222 685 2969  
E-mail: info@aryaninteriors.com